



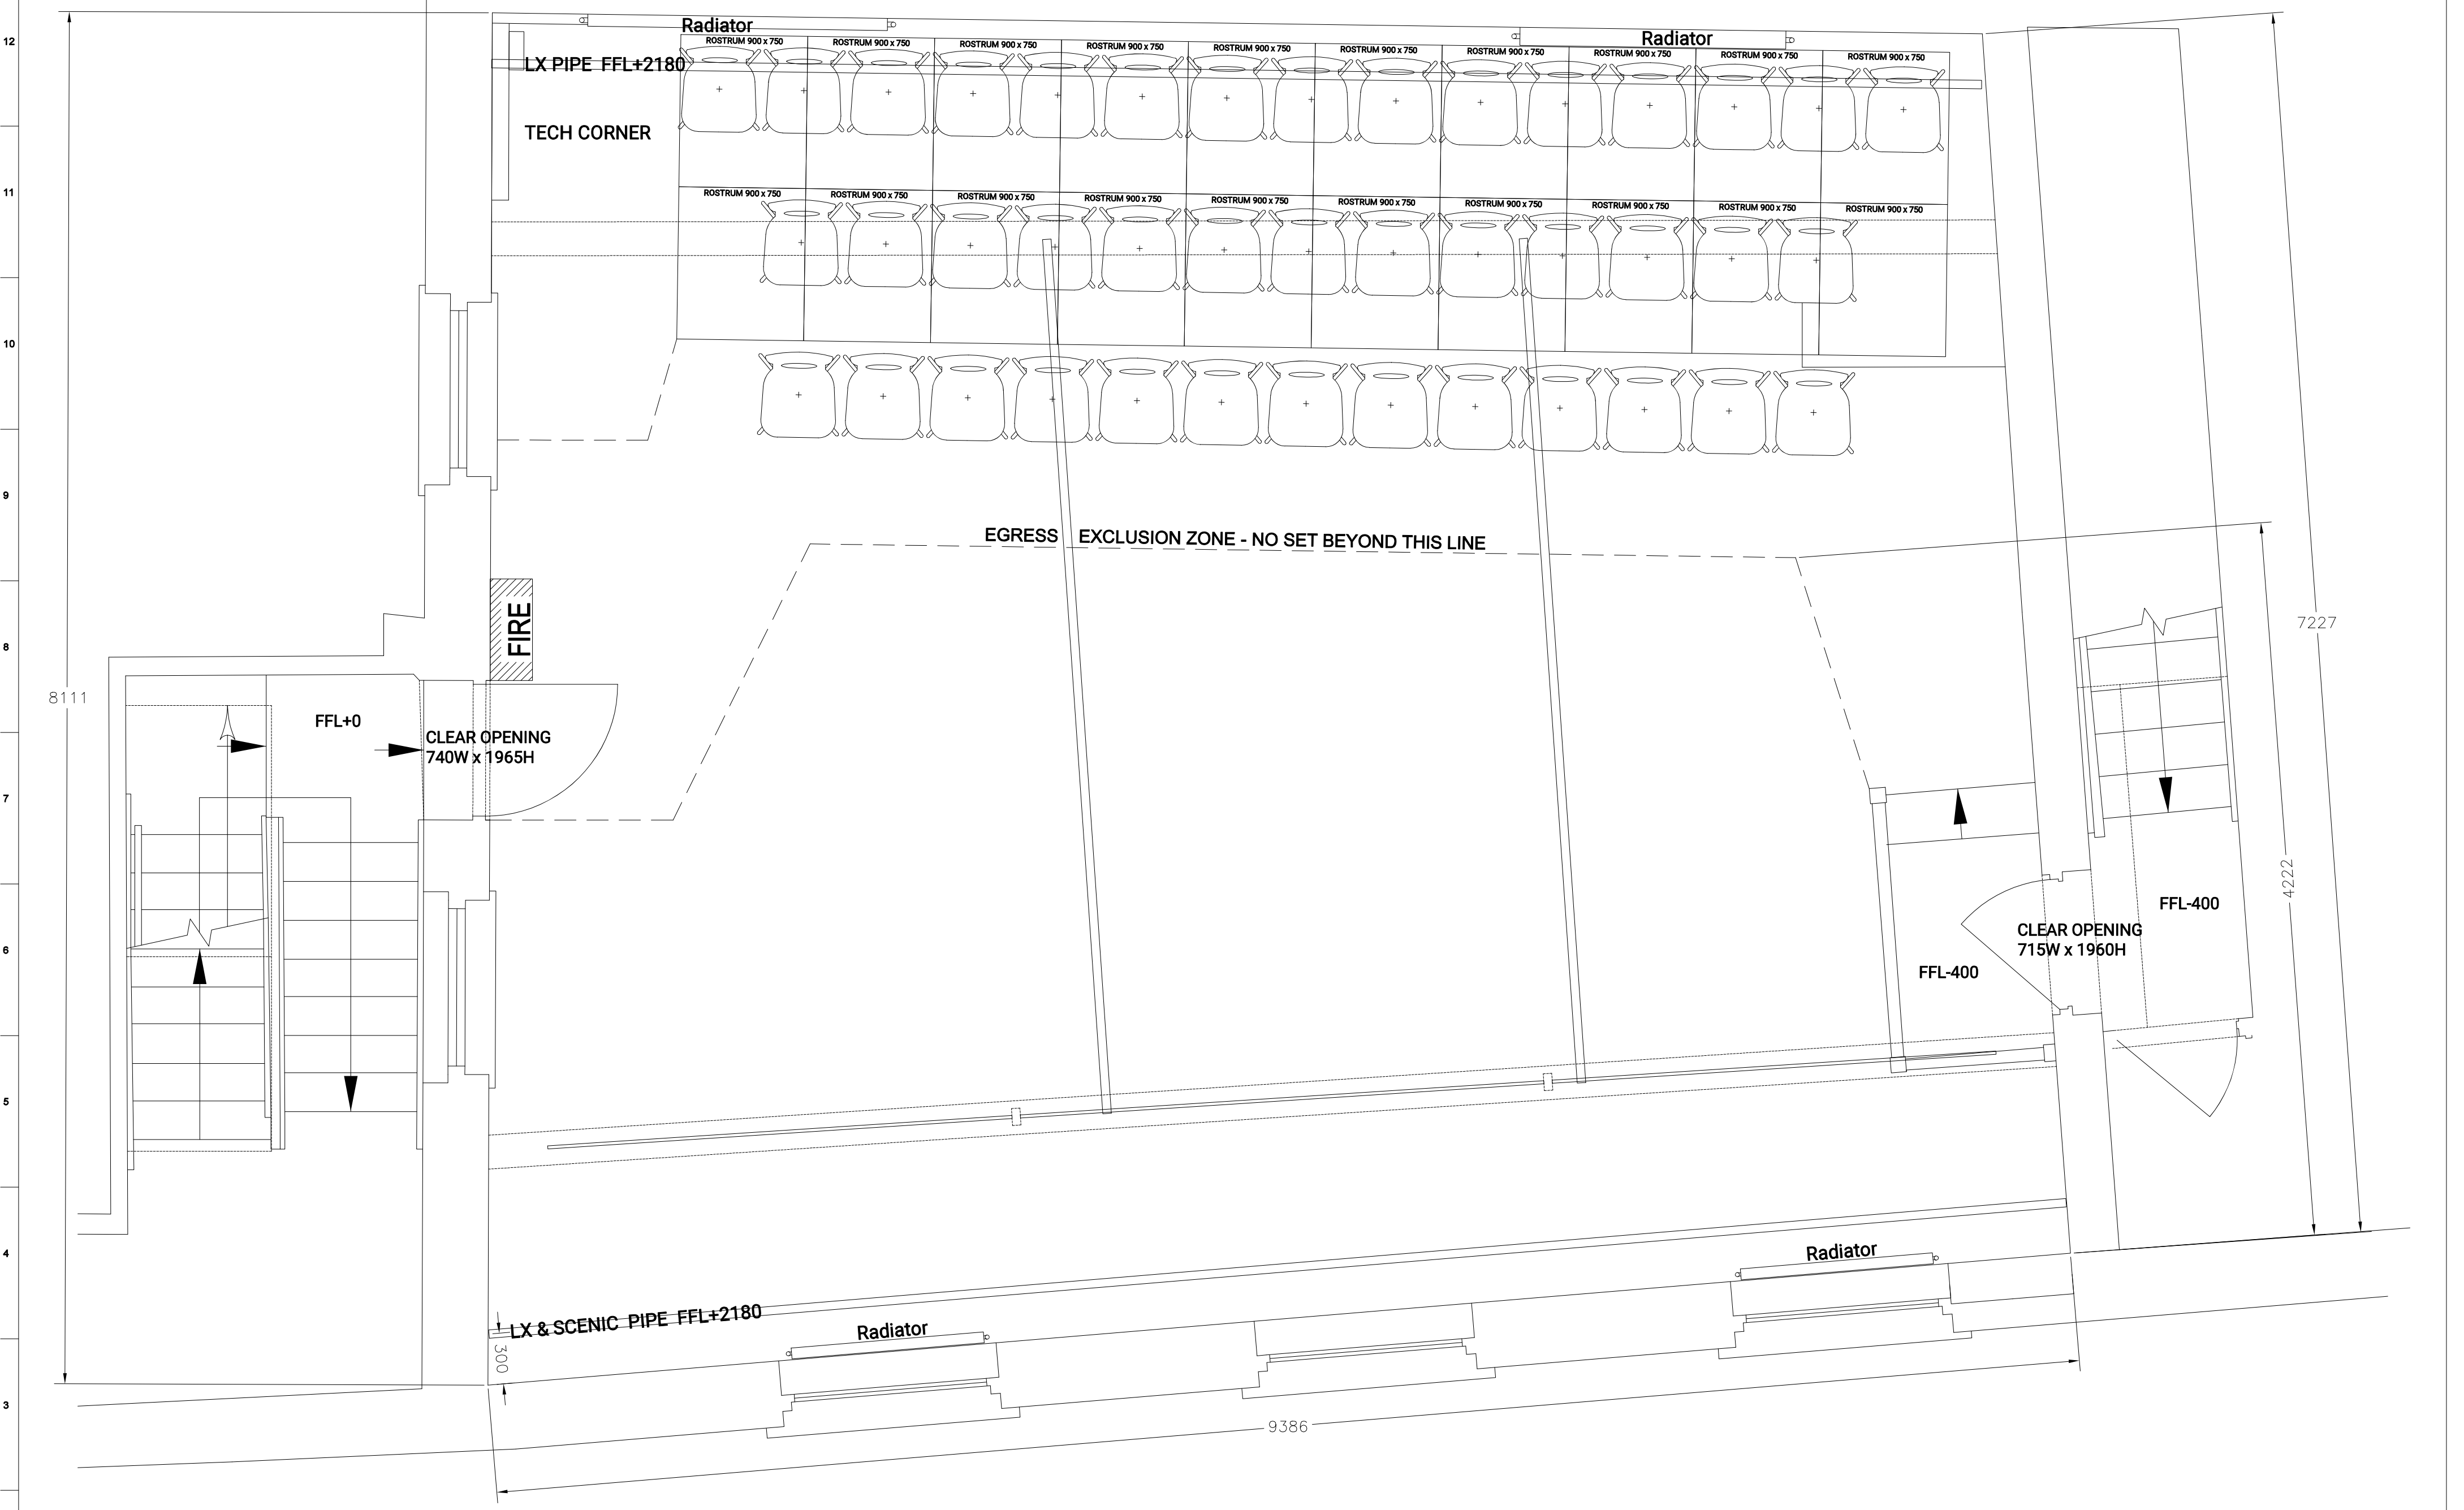

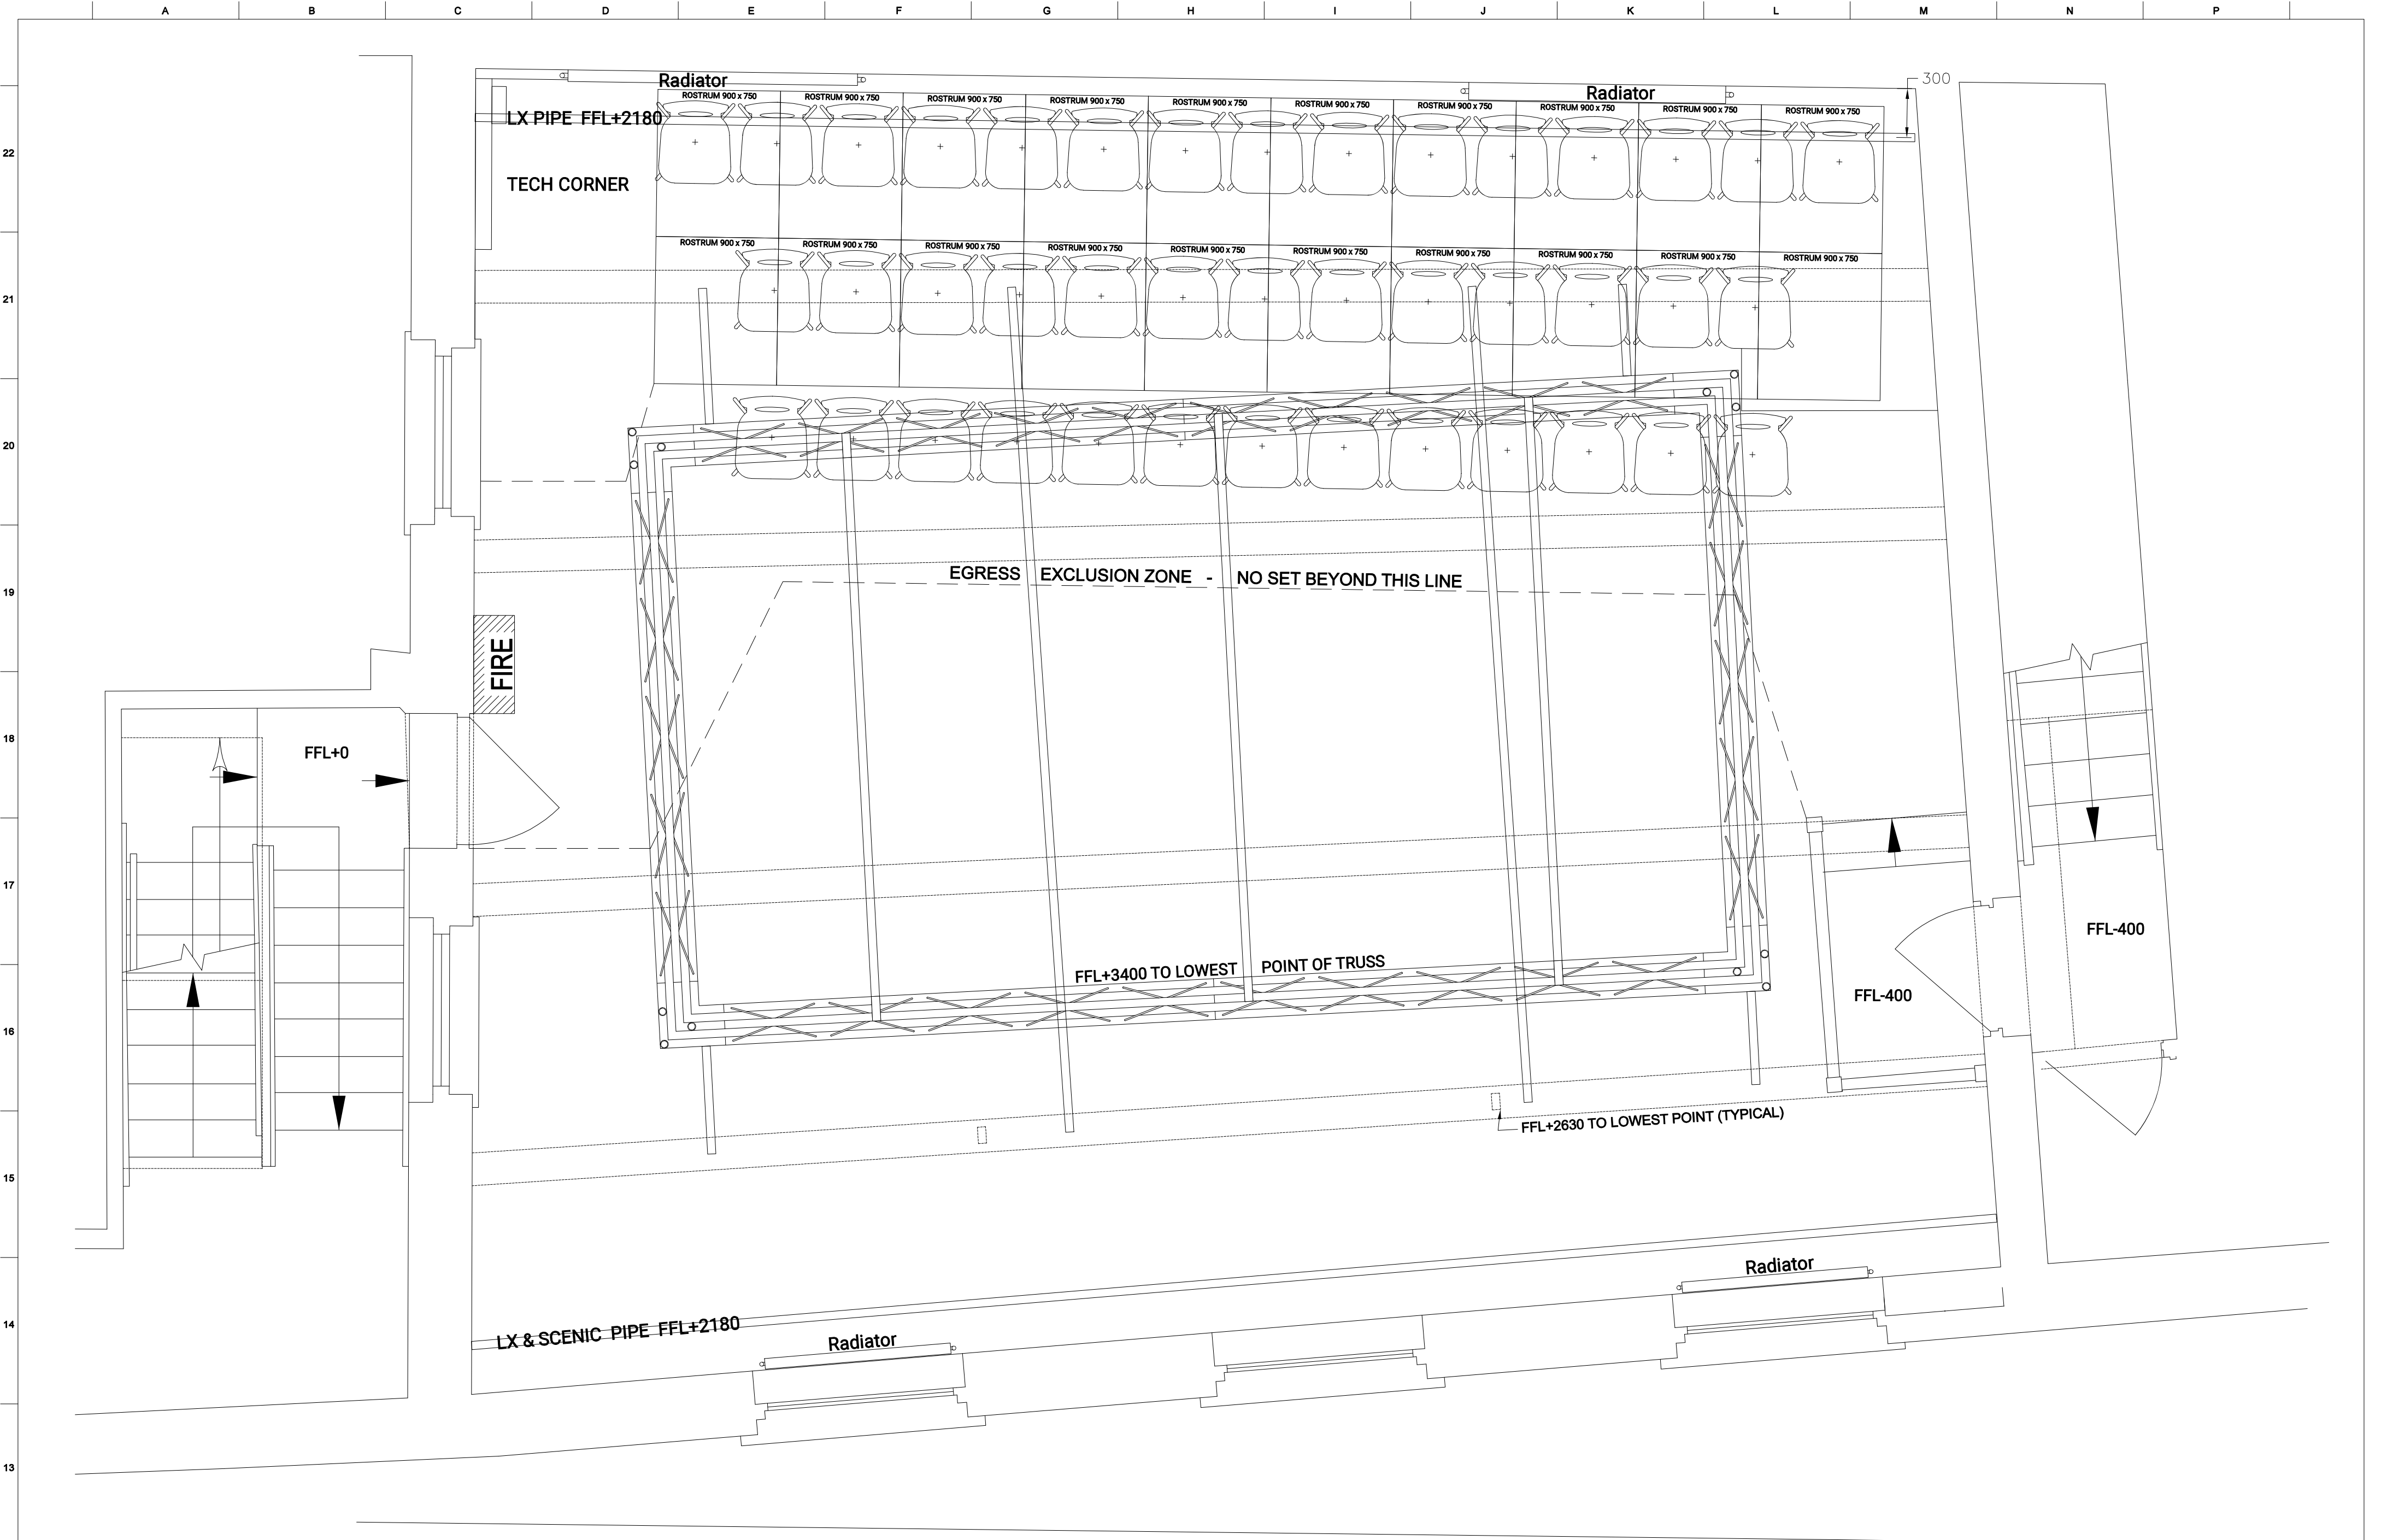

Project:
CORN EXCHANGE THEATRE
MARKET PLACE
WALLINGFORD, OXON
OX10 0EG

Design: ☐ Construction: ☐ As Built: ☒

THIS DRAWING/DESIGN OR ANY PART THERE OF, MAY NOT BE
REPRODUCED OR COMMUNICATED IN ANY FORM WITHOUT THE PRIOR
WRITTEN CONSENT OF CORN EXCHANGE WALLINGFORD LTD.

DRAWING STATUS

Venue/Area:
WARBURTON STUDIO THEATRE

System:
CO—ORDINATED

Title:
GENERAL ARRANGEMENT
PLAN VIEW
FOR SET DESIGN

Scale - on Paper Size
1:25 on A1

Engineer:
DS

Contract Number:
CX—REF

Drawn by:
DS

Approved:
BJW/MPB

DWG/CAD Reference Number:
02—001

Revision:
01

Production:

Drawing Title:

Designer:

Drawn By:

Date Drawn:

Rev:

01	10-09-25	DS	CHANGE TO WARBURTON STUDIO THEATRE
Rev	Date	By	Description

Approved:

GLOSSARY OF TERMS

FFL - FINISHED FLOOR LEVEL
LX - LIGHTING
LX PIPE - HORIZONTAL FIXED BAR FOR HANGING LIGHTS
STAGE LEFT - LEFT FROM THE PERSPECTIVE OF THE ENTERTAINER
AUDITORIUM LEFT - LEFT FROM THE PERSPECTIVE OF THE AUDIENCE

BASED ON 2023 LIDAR SURVEY AND SURVEY CARRIED OUT IN 2025 BY
ROBIN MYERSCOUGH-WALKER, BRUCE J WILLIAMS, AND DAVID SMITH
CAD PREPARED BY DAVID SMITH AND BRUCE J WILLIAMS
©2025 SINODUN PLAYERS & WALLINGFORD CORN EXCHANGE LTD