



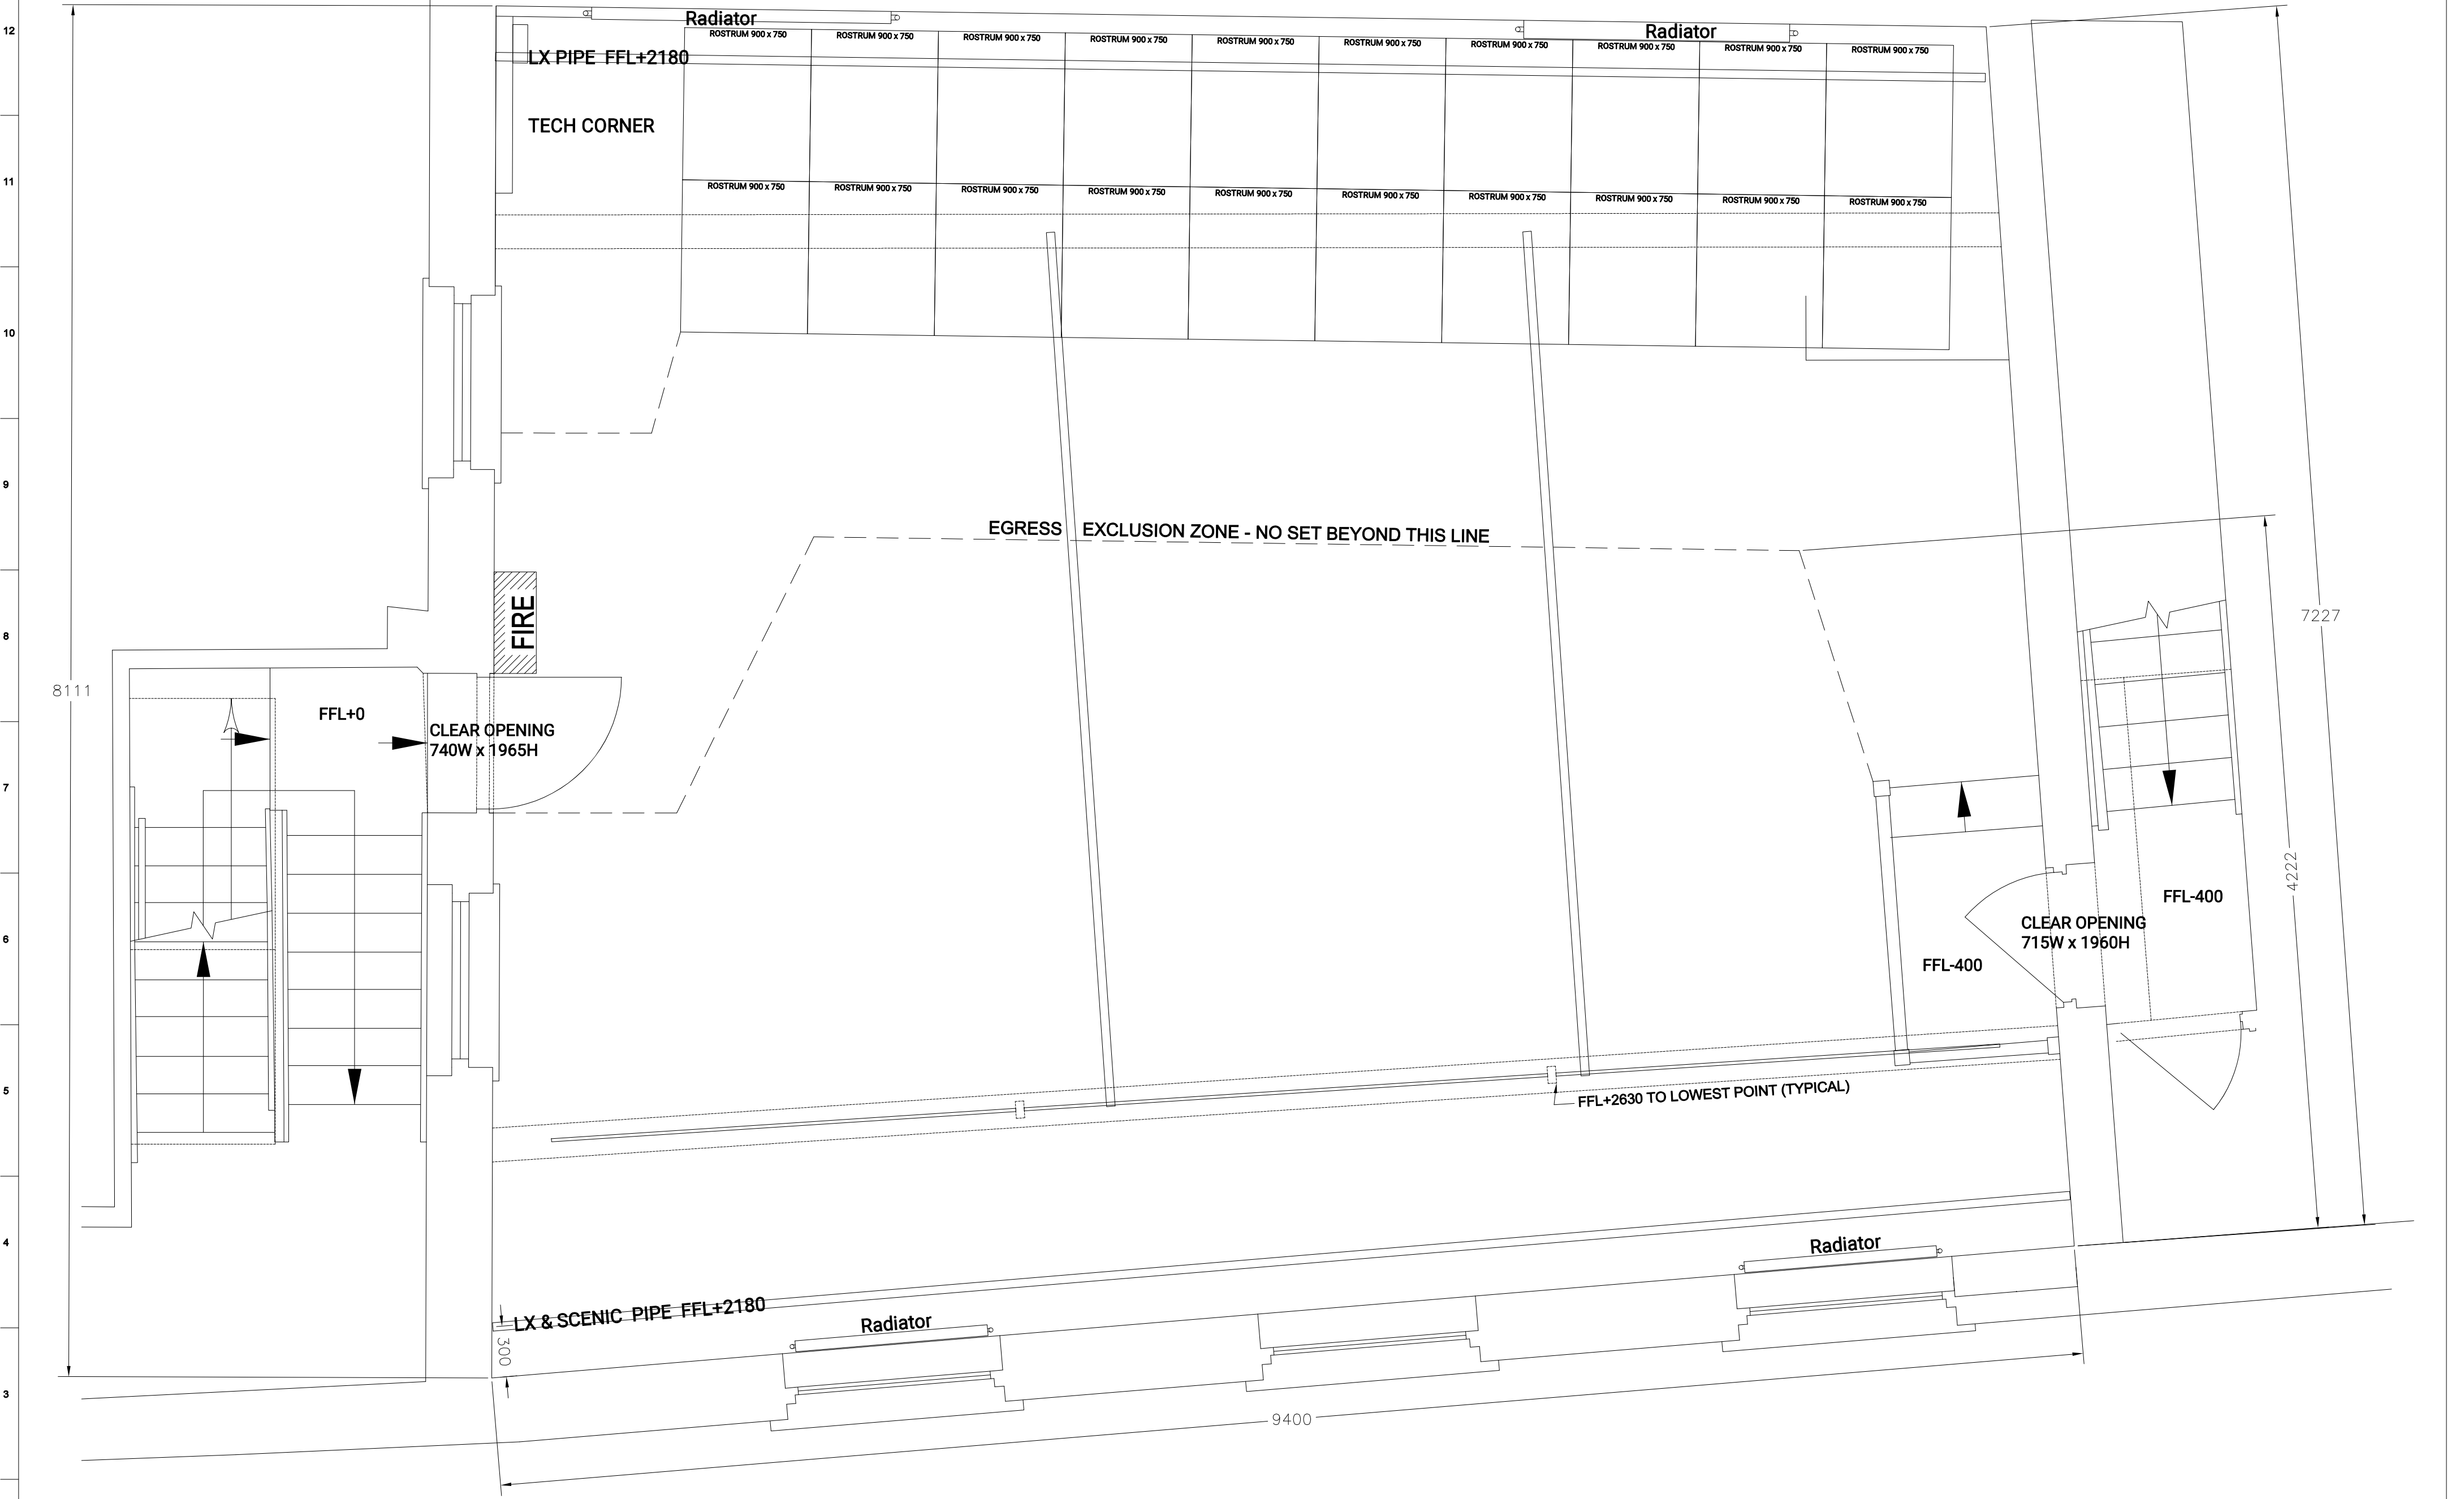

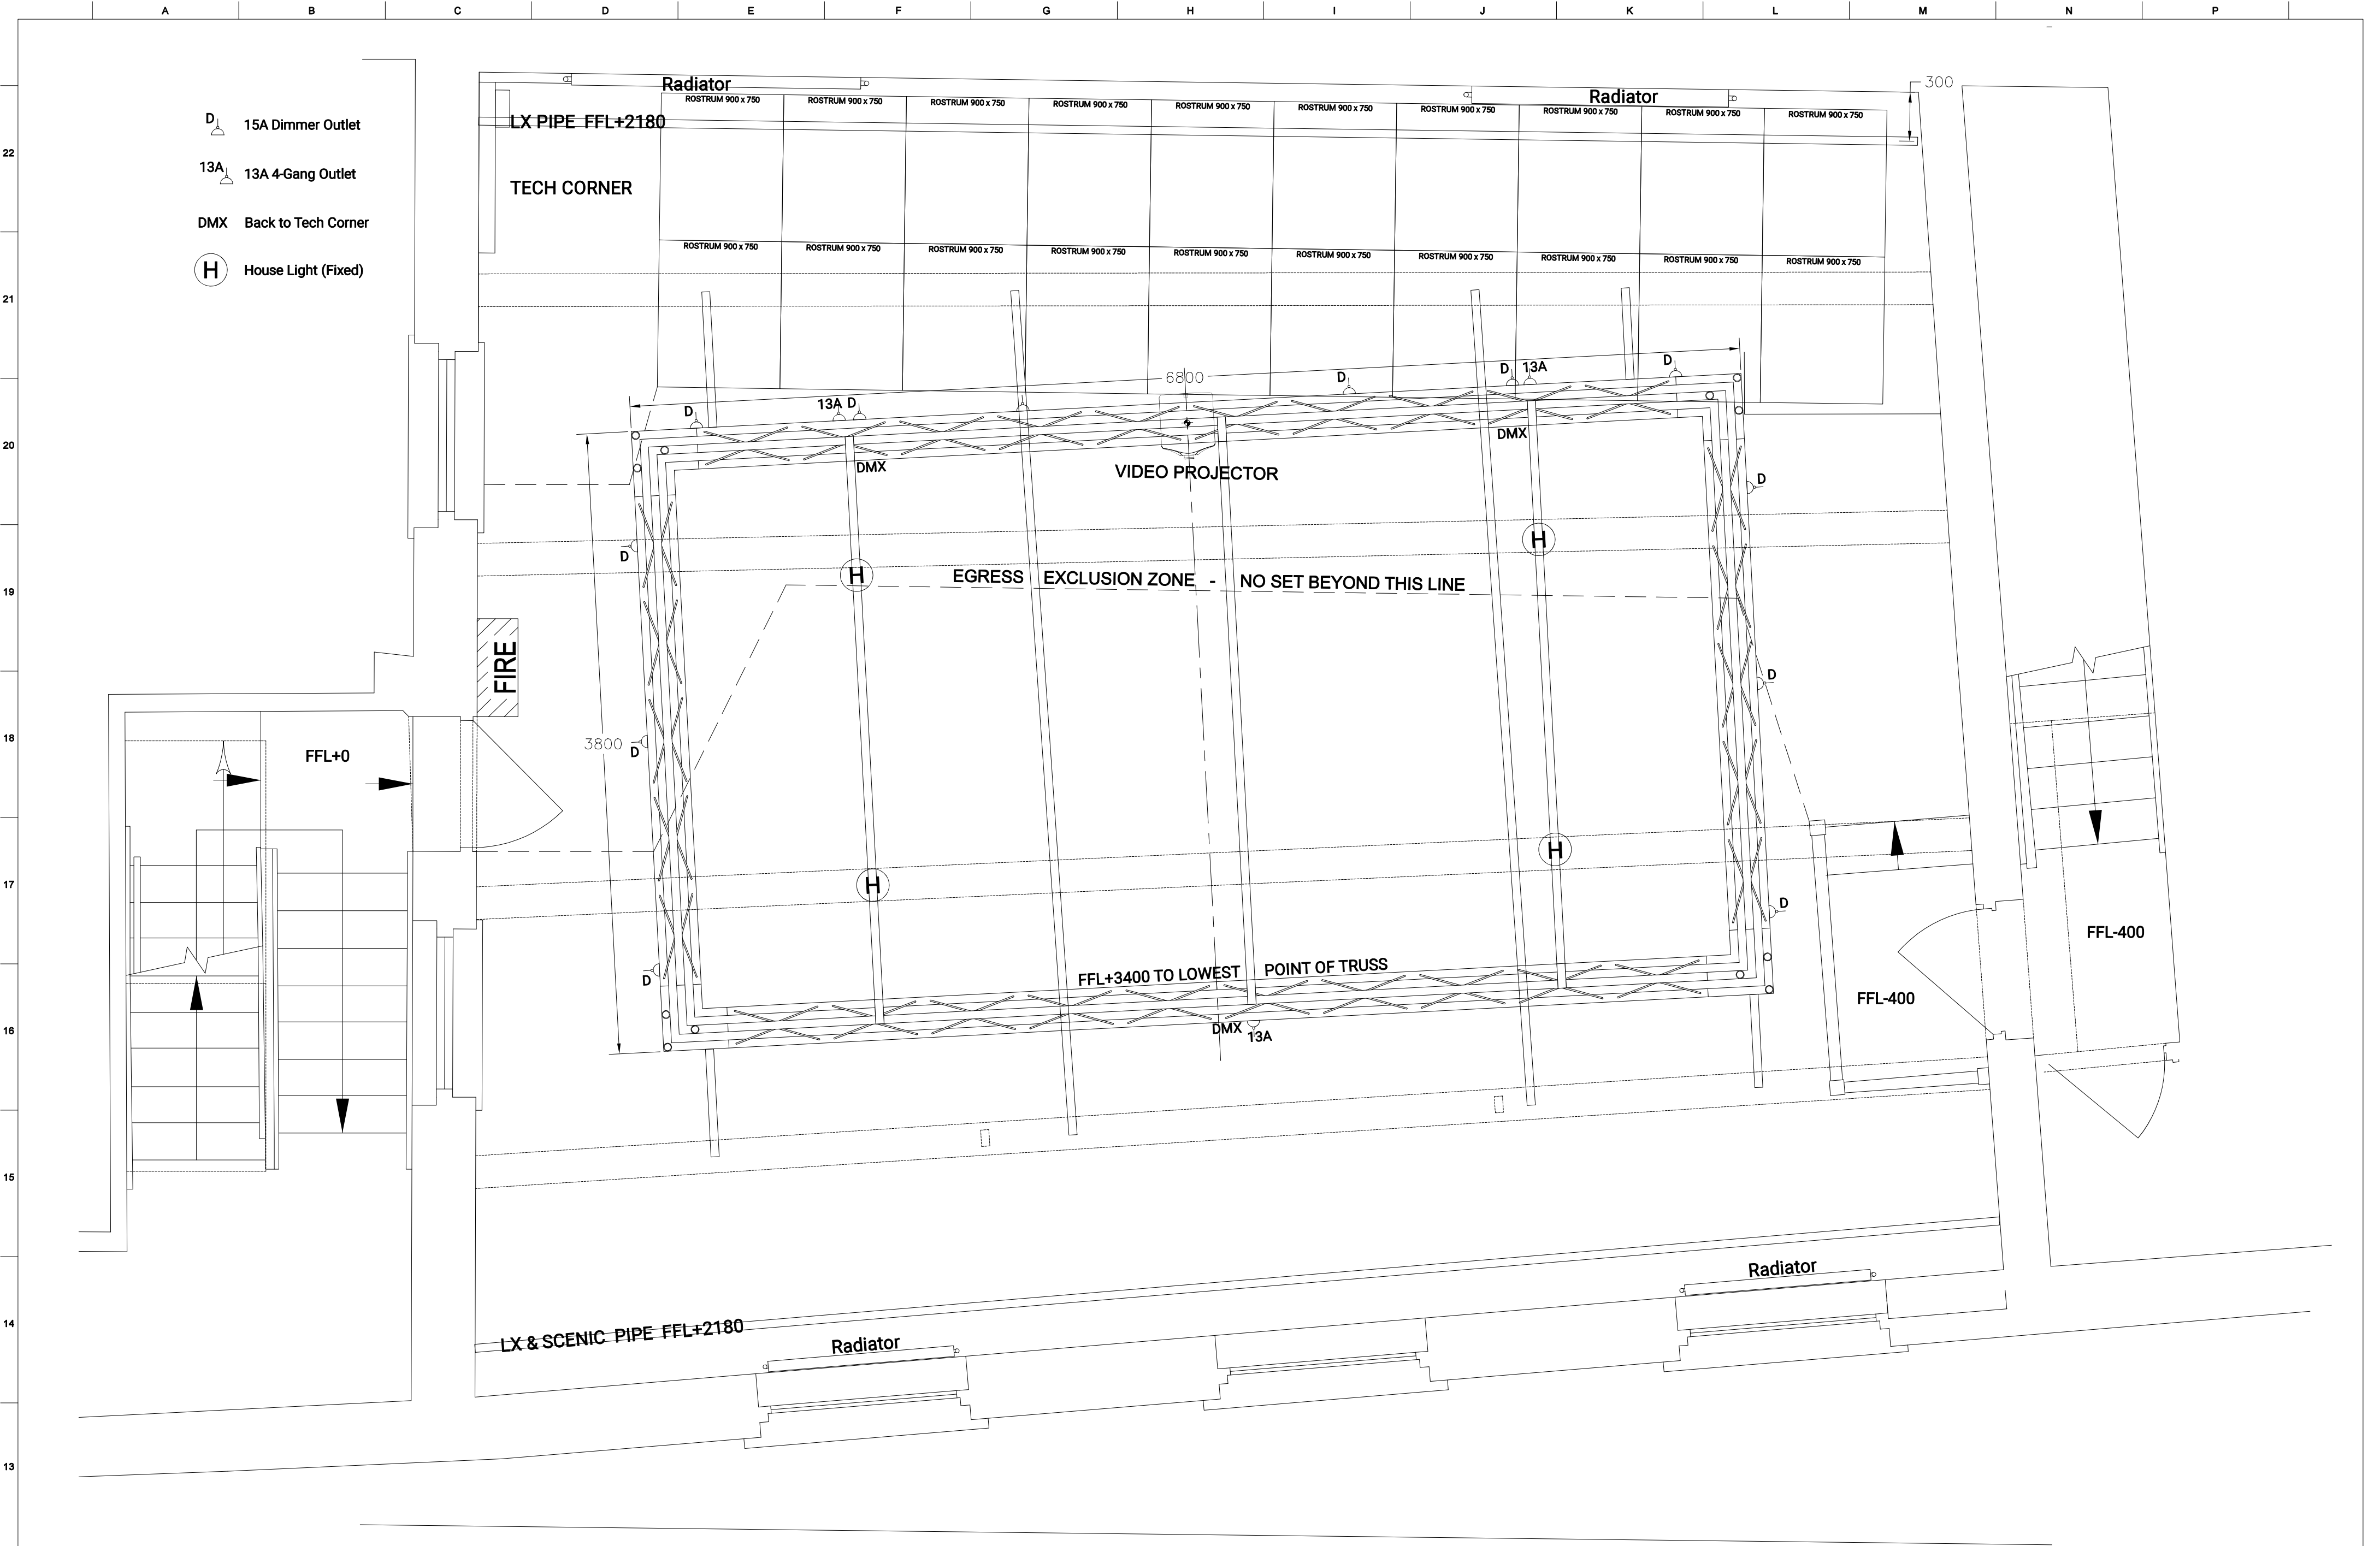

Project:  
CORN EXCHANGE THEATRE  
MARKET PLACE  
WALLINGFORD, OXON  
OX10 0EG

Design: ☐ Construction: ☐ As Built: ☒

THIS DRAWING/DESIGN OR ANY PART THERE OF, MAY NOT BE REPRODUCED OR COMMUNICATED IN ANY FORM WITHOUT THE PRIOR WRITTEN CONSENT OF CORN EXCHANGE WALLINGFORD LTD.

Venue/Area:  
WARBURTON STUDIO THEATRE

System:  
CO-ORDINATED

Title:  
GENERAL ARRANGEMENT  
PLAN VIEW  
FOR LIGHTING DESIGN

Scale - on Paper Size  
1:25 on A1

Contract Number:  
CX-REF

Drawn by:  
DS

Approved:  
BJW/MPB

DWG/CAD Reference Number:  
02-003

Revision:  
01

Date:  
18FEB25

Rev:  
01

Date:  
10-09-25

By:  
DS

Description:  
CHANGE TO WARBURTON STUDIO THEATRE

Production:

Drawing Title:

Designer:

Drawn By:

Date Drawn:

Rev:

Approved:

GLOSSARY OF TERMS

FFL - FINISHED FLOOR LEVEL  
LX - LIGHTING  
LX PIPE - HORIZONTAL FIXED BAR FOR HANGING LIGHTS  
STAGE LEFT - LEFT FROM THE PERSPECTIVE OF THE ACTORS  
AUDITORIUM LEFT - LEFT FROM THE PERSPECTIVE OF THE AUDIENCE

BASED ON 2023 LIDAR SURVEY AND SURVEY CARRIED OUT IN 2025 BY ROBIN MYERSCOUGH-WALKER, BRUCE J WILLIAMS, AND DAVID SMITH  
CAD PREPARED BY DAVID SMITH AND BRUCE J WILLIAMS  
©2025 SINODUN PLAYERS & WALLINGFORD CORN EXCHANGE LTD